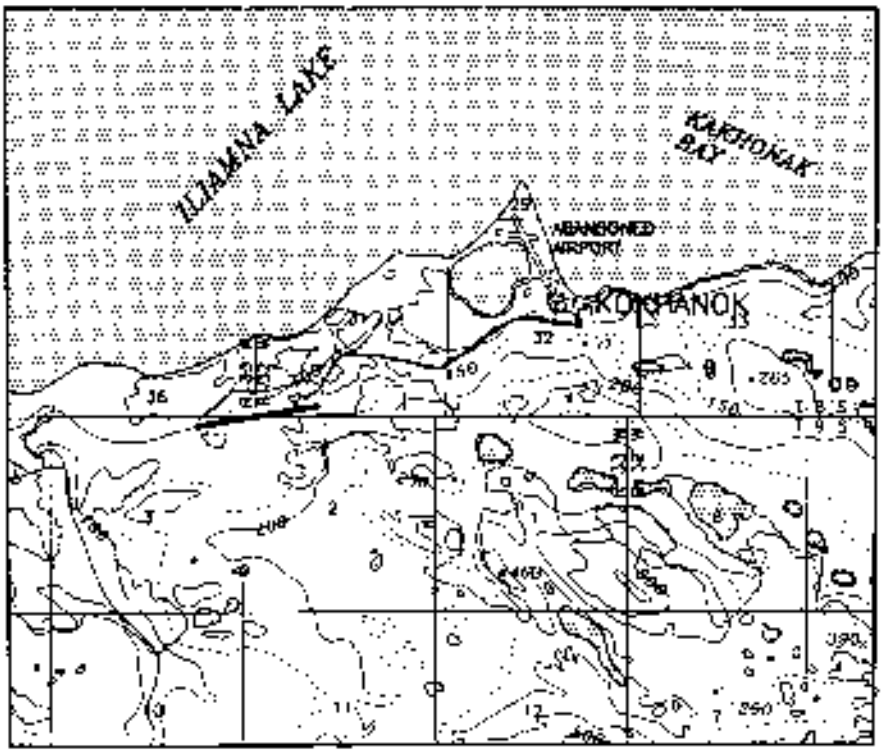

VICINITY MAP

Kokhanok Airport
T8S, R32W, SEC. 31
T8S, R33W, SEC. 36
T9S, R33W, SEC. 2 & 3
SEWARD MERIDIAN
Nomna (B-5), Alaska
1954, Revised 1966
Airport As-built 1999

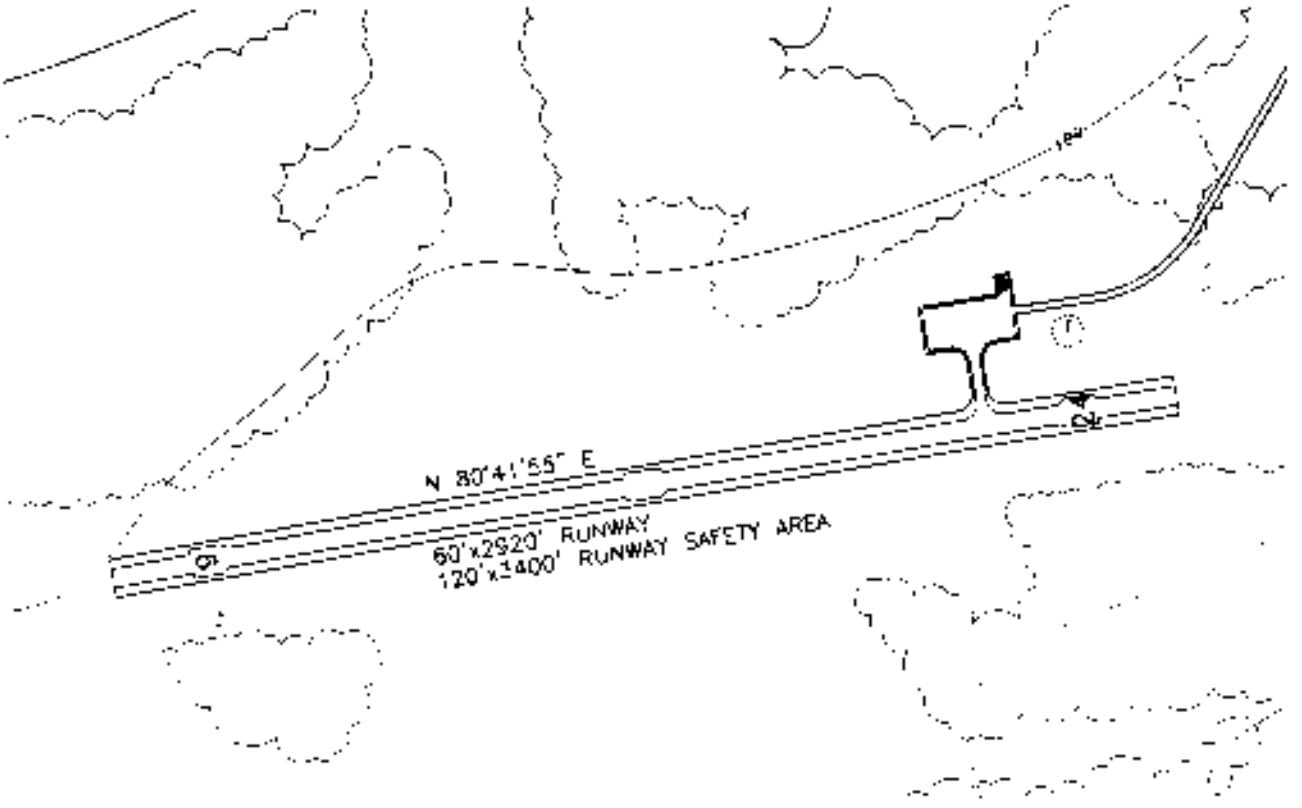

AIRPORT NAME: **KOKHANOK AIRPORT**	DRAWN BY:	CHECKED BY:
AIRPORT CODE: 50426.25.9K2	SCALE: 1"=600'	SHEET OF 2
FILE:	DATE: 12-3-99	
DATE:		